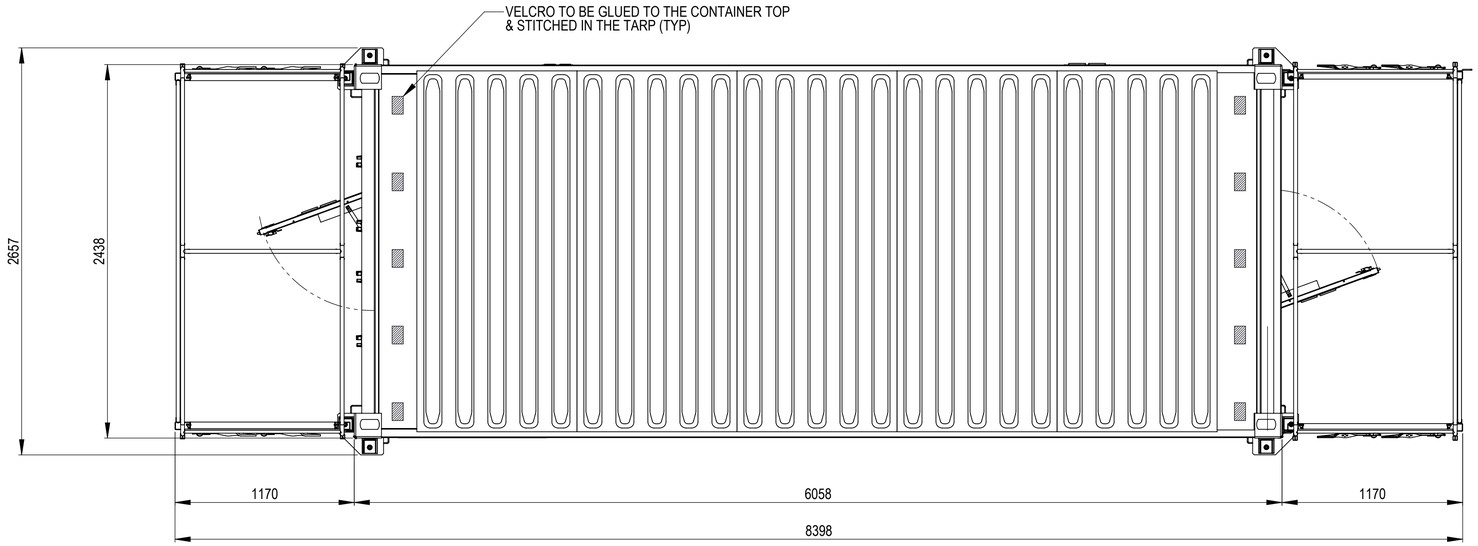

TOP VIEW

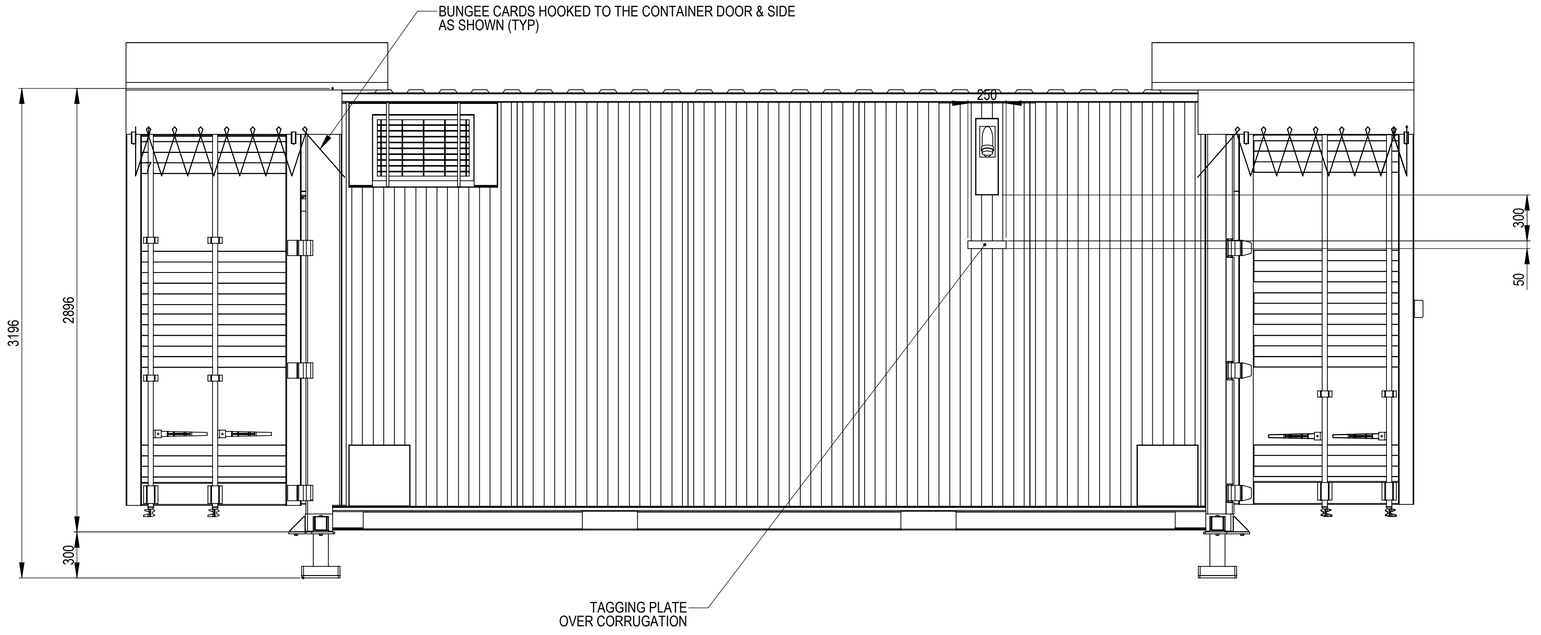

LEFT VIEW

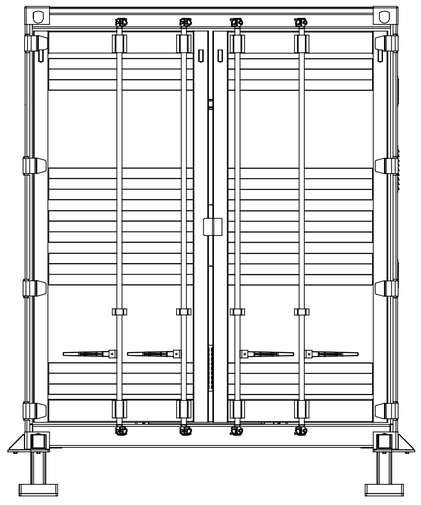

REAR VIEW
(DOOR CLOSED)

CONTAINER NUMBER : 9702507
PAINT COLOUR : GRIFFITH CORPORATE RED
TARP COLOUR : BLACK

NOTE:
- 1x 32AMP THREE PHASE POWER INLET
- LED STRIP LIGHTS WITH DRIVERS, INDEPENDENTLY SWITCHED
- 1x 24 POLE DISTRIBUTION BOARD
- 1x 150MM DIA FAN IN LABORATORY - INDEPENDENTLY SWITCHED
- 2x 100MM DIA FANS IN INSECTARY - INDEPENDENTLY SWITCHED, 1x FAN CONNECTED TO CONTINUOUS OPERATION, 1x FAN - LIGHT SWITCH OPERATED
- FLY SCREEN MESH ADDED TO 3x, EXHAUST FAN VENTILATORS

APPROVED

REV.	DATE	DESCRIPTION	DRN	APP.
1	19/02/2020	AS BUILT	SN	WL
0	13/12/2019	APPROVED FOR CONSTRUCTION	SN	GL

REVISIONS

Royal Wolf Trading Australia Pty Ltd
ABN 38 069 244 417
www.royalwolf.com.au

Scale	1:20	
Mass	-- kg	
Drawn	SN	10/03/20
Checked	-	-
Designed	RWT	08/11/19
Approved	WL	10/03/20

General Fabrication Tolerances
0-50 mm ; ±0.5 mm
51mm-1M ; ±1.0 mm
1.001M - 6.1 M ; ±2.0 mm
6.101 M - 13 M ; ±3.0 mm

Customer: GRIFFITH UNI

Project: C-LAB

Division: SPECIAL PROJECTS

Title: C-LAB CONTAINER GENERAL ARRANGEMENT

Sheet Size: A1 | Third Angle | Sheet No.: SHEET 1 OF 7

RWT Drawing Number: P19065-001

REV: 1

THIS DRAWING IS THE PROPERTY OF ROYAL WOLF TRADING AUSTRALIA PTY LTD AND IS CONDITIONALLY LOANED TO THE RECIPIENT WHO BY RECEIVING IT HAS AGREED NOT TO REPRODUCE IT IN WHOLE OR IN PART, NOR MAKE ANY USE OF IT THAT HAS NOT BEEN APPROVED IN WRITING BY ROYAL WOLF TRADING AUSTRALIA PTY LTD

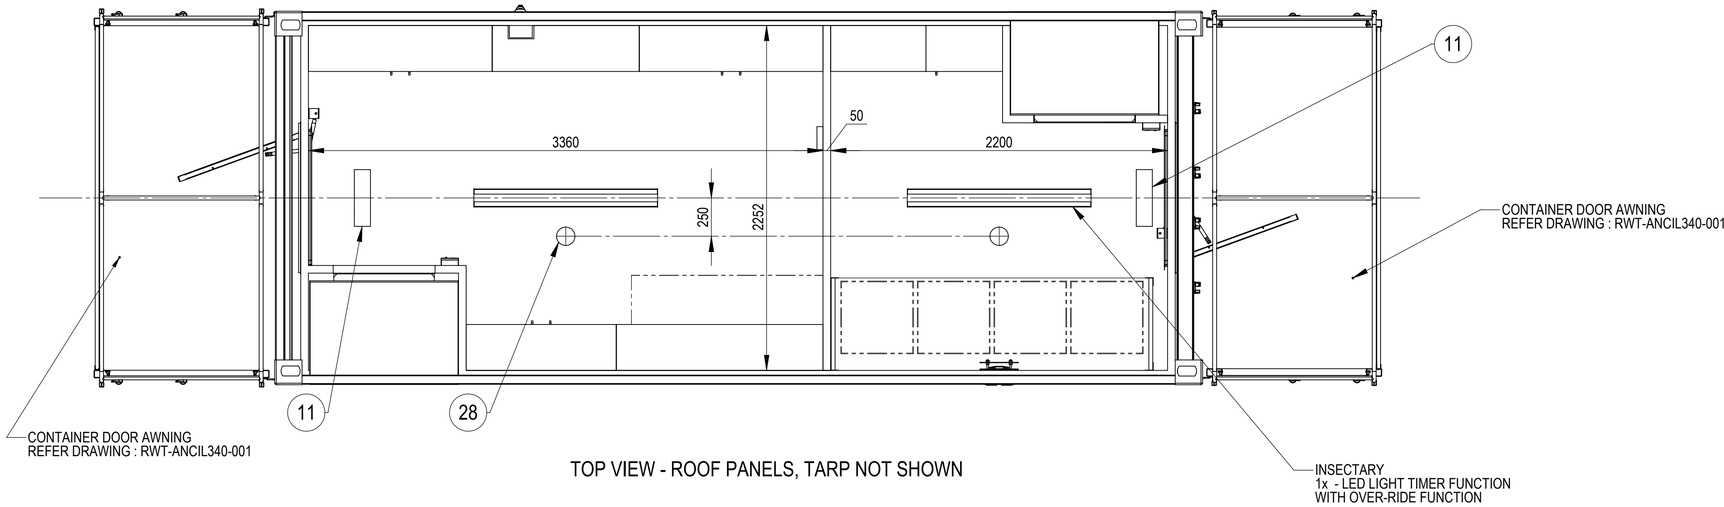

TOP VIEW - ROOF PANELS, TARP NOT SHOWN

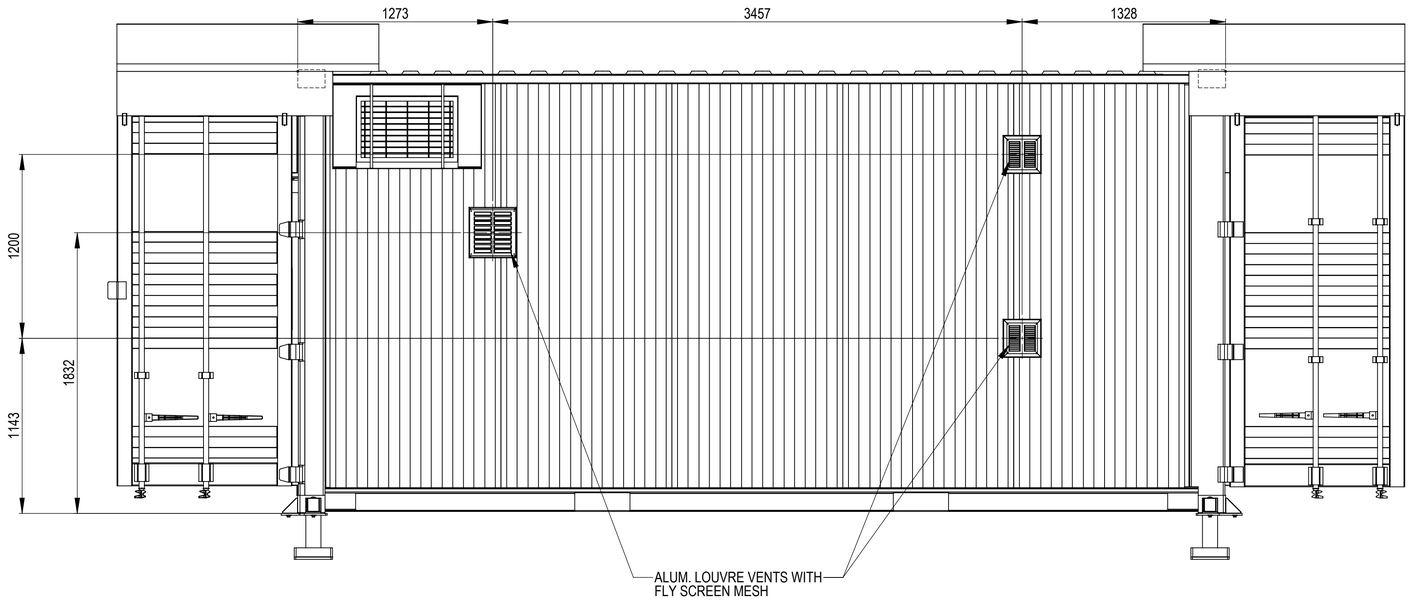

RIGHT VIEW
(BUNGEE CORDS NOT SHOWN)

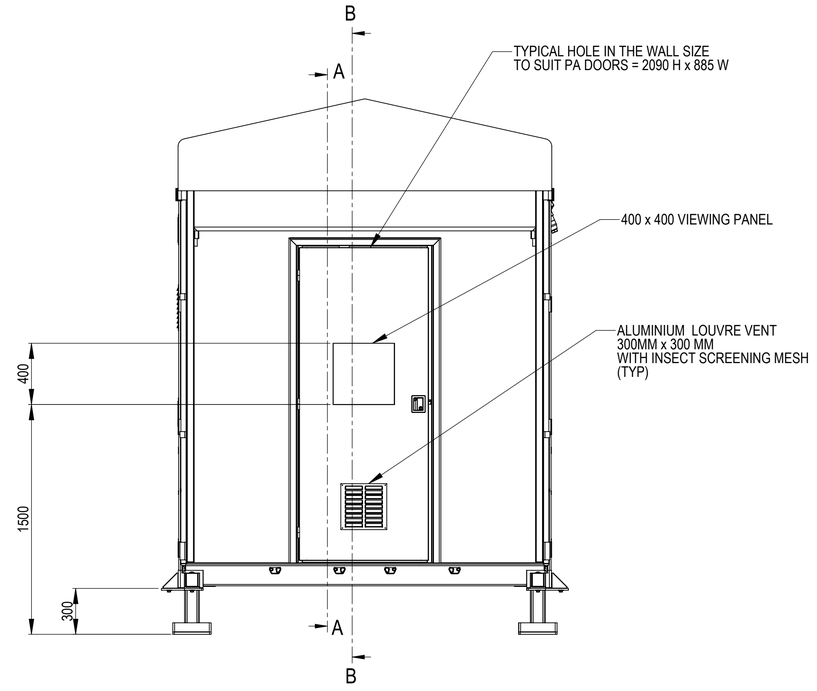

FRONT VIEW
(CONTAINER DOORS OPENED,
PA DOOR CLOSED)

APPROVED

Royal Wolf Trading Australia Pty Ltd
ABN 38 069 244 417
www.royalwolf.com.au

Scale	1:20	
Mass	-- kg	
Drawn	SN	10/03/20
Checked	-	-
Designed	RWT	08/11/19
Approved	WL	10/03/20

General Fabrication Tolerances
0-50 mm ; ±0.5 mm
51mm-1M ; ±1.0 mm
1.001M - 6.1 M ; ±2.0 mm
6.101 M - 13 M ; ±3.0 mm

Customer: GRIFFITH UNI

Project: C-LAB

Division: SPECIAL PROJECTS

THIS DRAWING IS THE PROPERTY OF ROYAL WOLF TRADING AUSTRALIA PTY LTD AND IS CONDITIONALLY LOANED TO THE RECIPIENT WHO BY RECEIVING IT HAS AGREED NOT TO REPRODUCE IT IN WHOLE OR IN PART, NOR MAKE ANY USE OF IT THAT HAS NOT BEEN APPROVED IN WRITING BY ROYAL WOLF TRADING AUSTRALIA PTY LTD

Sheet Size: A1 | Third Angle | Sheet No.: SHEET 2 OF 7

Title: C-LAB CONTAINER GENERAL ARRANGEMENT

RWT Drawing Number: P19065-001

REV: 1

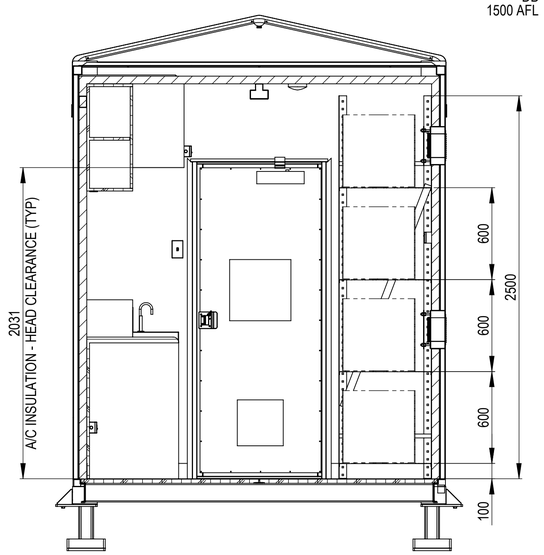

SECTION D-D

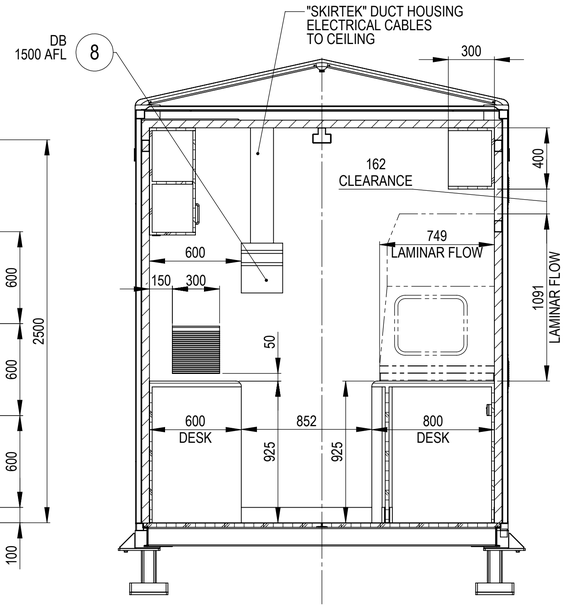

SECTION C-C

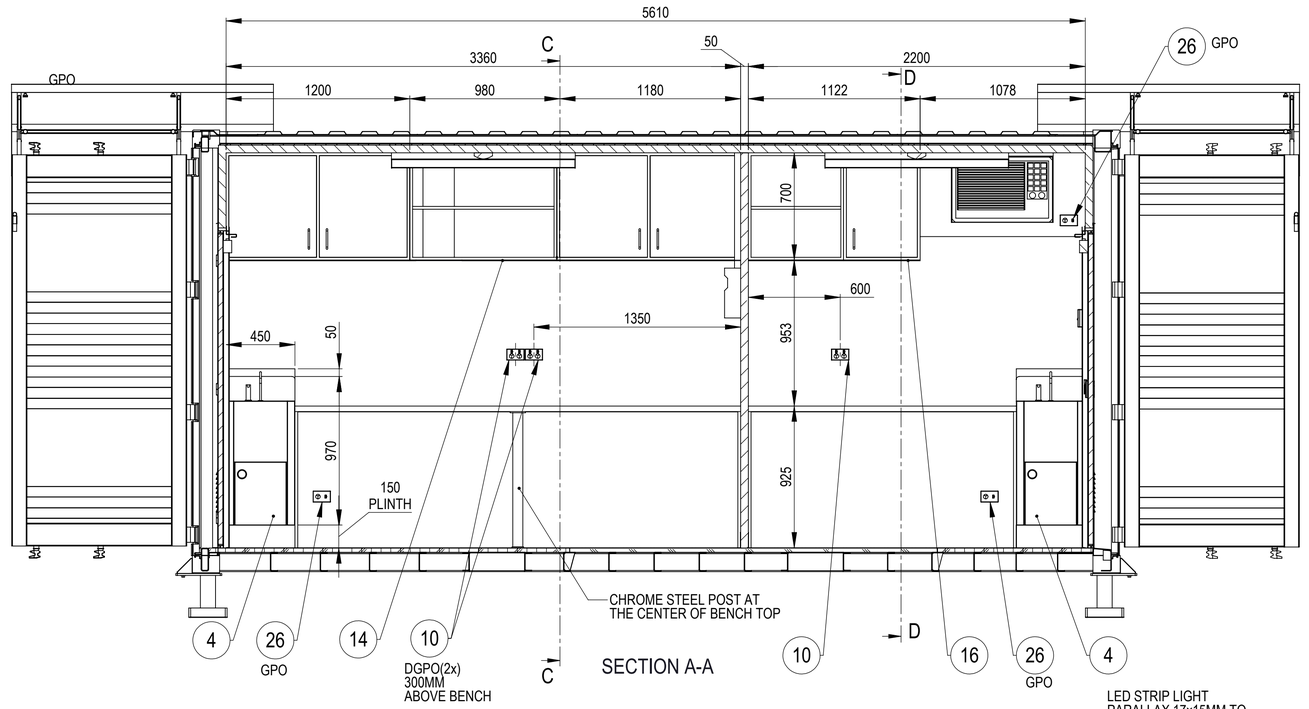

SECTION A-A

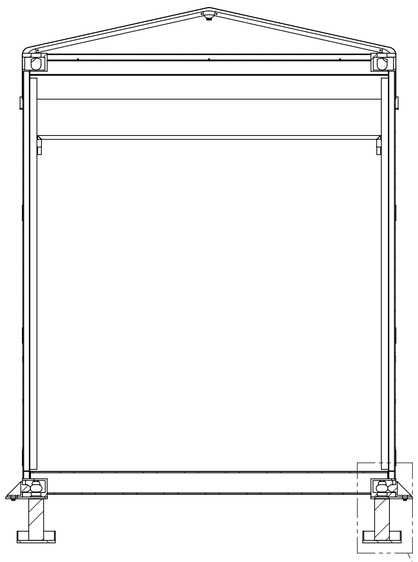

SECTION F-F

SILICON SEAL GABLE ENDS
TO VINYL FLOOR

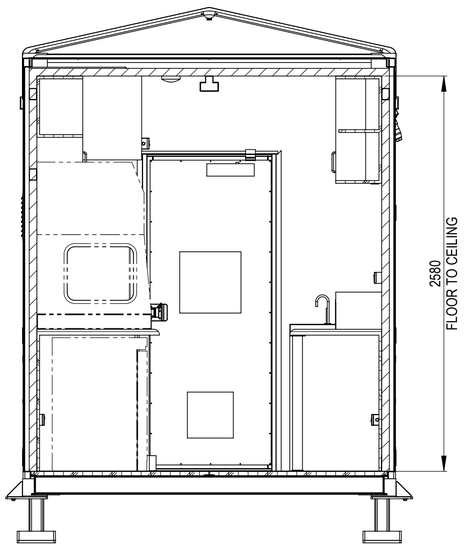

SECTION E-E

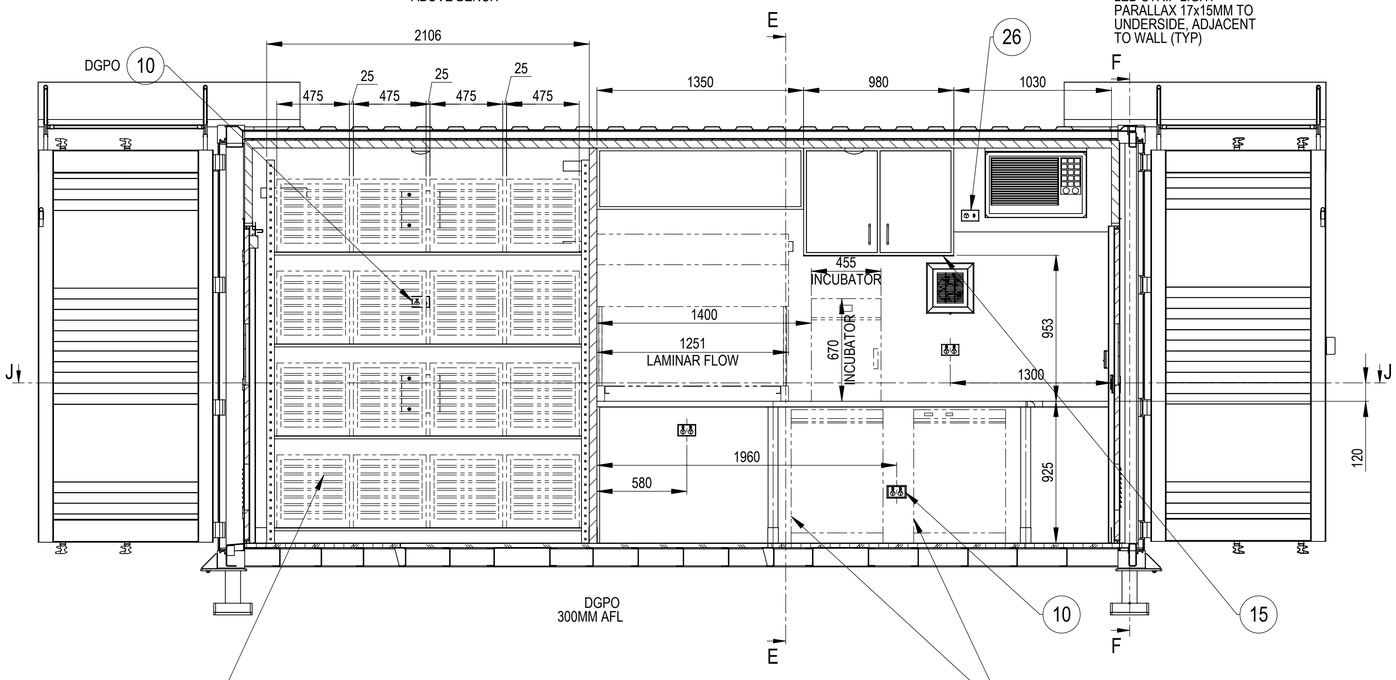

SECTION B-B

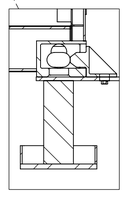

DETAIL G
SCALE: 1 : 10

TYPICAL PULL HANDLE
& S/S SASH RETAINER TAB
IN CUPBOARDS

APPROVED

Royal Wolf Trading Australia Pty Ltd
ABN 38 069 244 417
www.royalwolf.com.au

Scale	1:20		
Mass	-- kg		
Drawn	SN	10/03/20	
Checked	-	-	
Designed	RWT	08/11/19	
Approved	WL	10/03/20	

General Fabrication Tolerances
0-50 mm ; ±0.5 mm
51mm-1M ; ±1.0 mm
1.001M - 6.1 M ; ±2.0 mm
6.101 M - 13 M ; ±3.0 mm

Customer: GRIFFITH UNI

Project: C-LAB

Division: SPECIAL PROJECTS

Sheet Size: A1 | Third Angle | Sheet No.: SHEET 3 OF 7

Title: C-LAB CONTAINER GENERAL ARRANGEMENT

RWT Drawing Number: P19065-001

REV: 1

THIS DRAWING IS THE PROPERTY OF ROYAL WOLF TRADING AUSTRALIA PTY LTD AND IS CONDITIONALLY LOANED TO THE RECIPIENT WHO BY RECEIVING IT HAS AGREED NOT TO REPRODUCE IT IN WHOLE OR IN PART, NOR MAKE ANY USE OF IT THAT HAS NOT BEEN APPROVED IN WRITING BY ROYAL WOLF TRADING AUSTRALIA PTY LTD

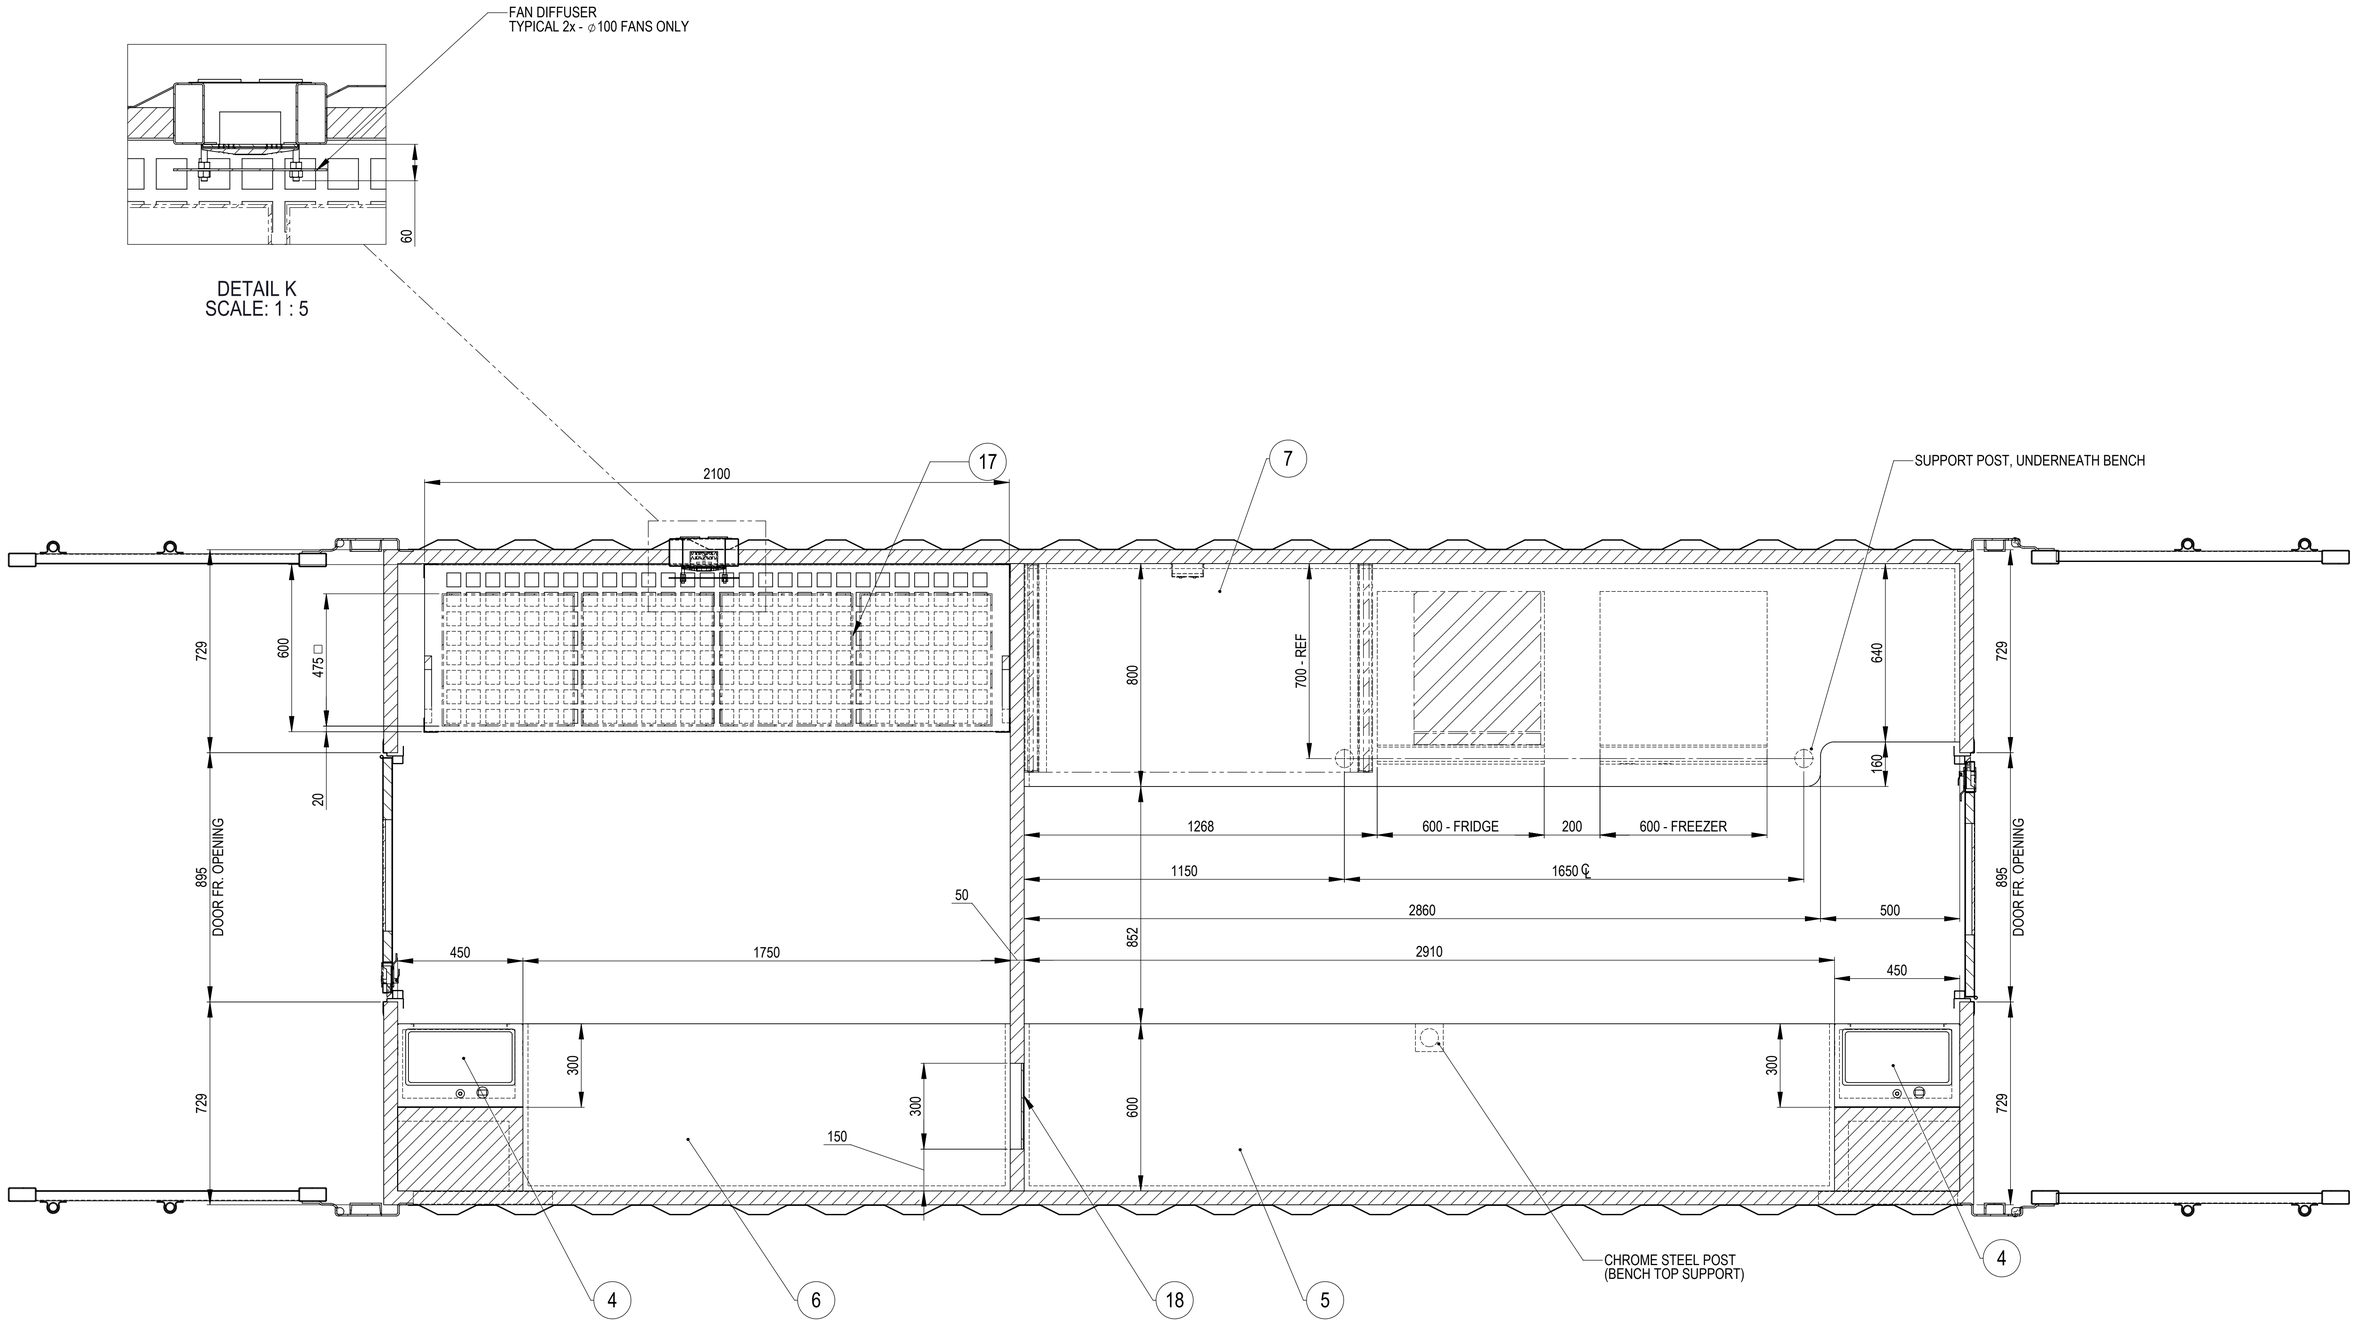

SECTION J-J
SCALE 1:10

APPROVED

Royal Wolf Trading Australia Pty Ltd
ABN 38 069 244 417
www.royalwolf.com.au

Scale	1:20	
Mass	-- kg	
Drawn	SN	10/03/20
Checked	-	-
Designed	RWT	08/11/19
Approved	WL	10/03/20

General Fabrication Tolerances
0-50 mm ; ±0.5 mm
51mm-1M ; ±1.0 mm
1.001M - 6.1 M ; ±2.0 mm
6.101 M - 13 M ; ±3.0 mm

Customer: GRIFFITH UNI
Project: C-LAB
Division: SPECIAL PROJECTS

THIS DRAWING IS THE PROPERTY OF ROYAL WOLF TRADING AUSTRALIA PTY LTD AND IS CONDITIONALLY LOANED TO THE RECIPIENT WHO BY RECEIVING IT HAS AGREED NOT TO REPRODUCE IT IN WHOLE OR IN PART, NOR MAKE ANY USE OF IT THAT HAS NOT BEEN APPROVED IN WRITING BY ROYAL WOLF TRADING AUSTRALIA PTY LTD

Sheet Size: A1 (Third Angle)
Sheet No.: SHEET 4 OF 7

Title: C-LAB CONTAINER GENERAL ARRANGEMENT
RWT Drawing Number: P19065-001
REV: 1

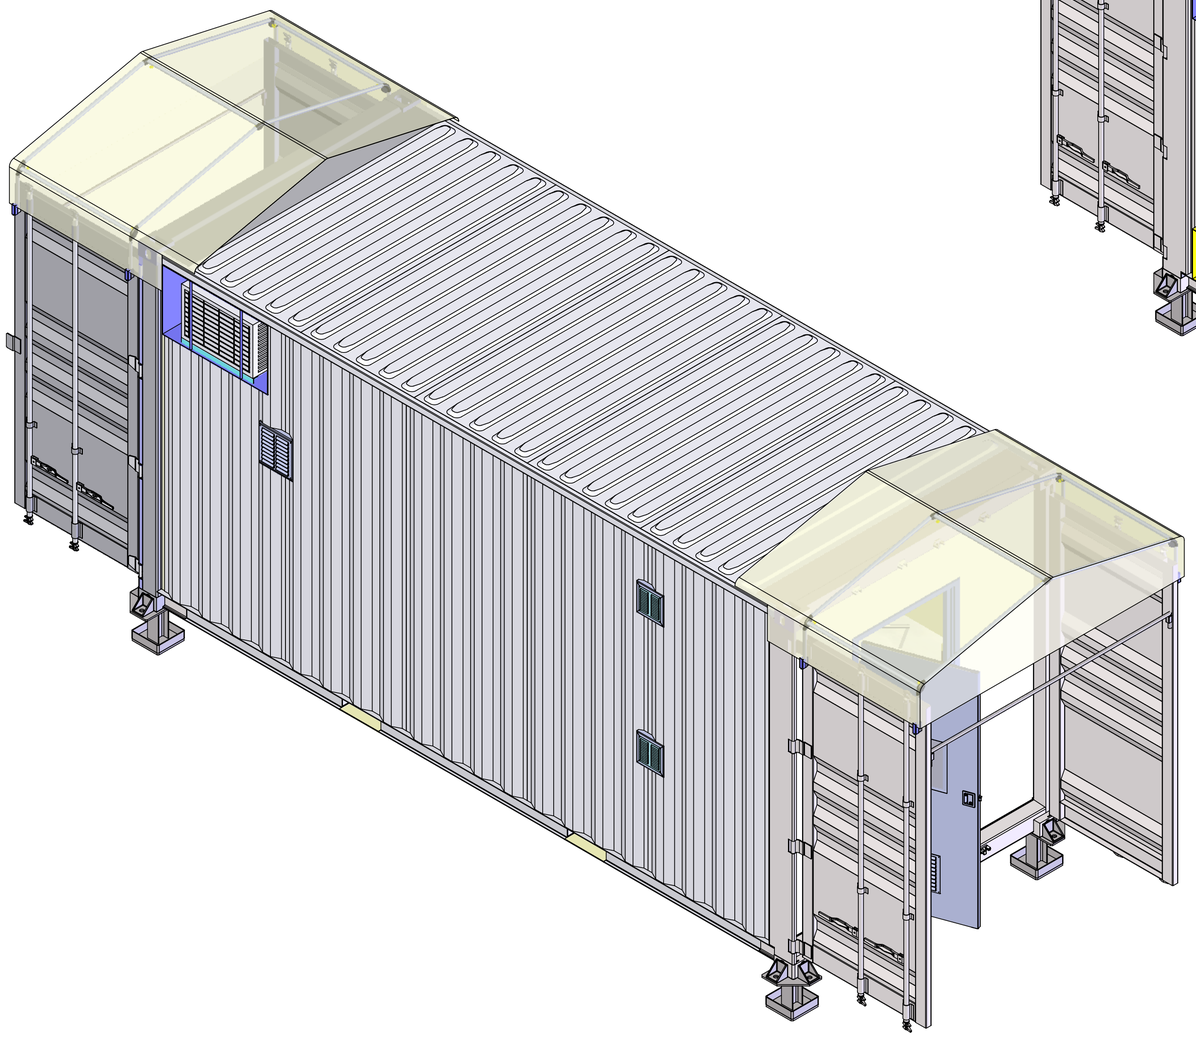

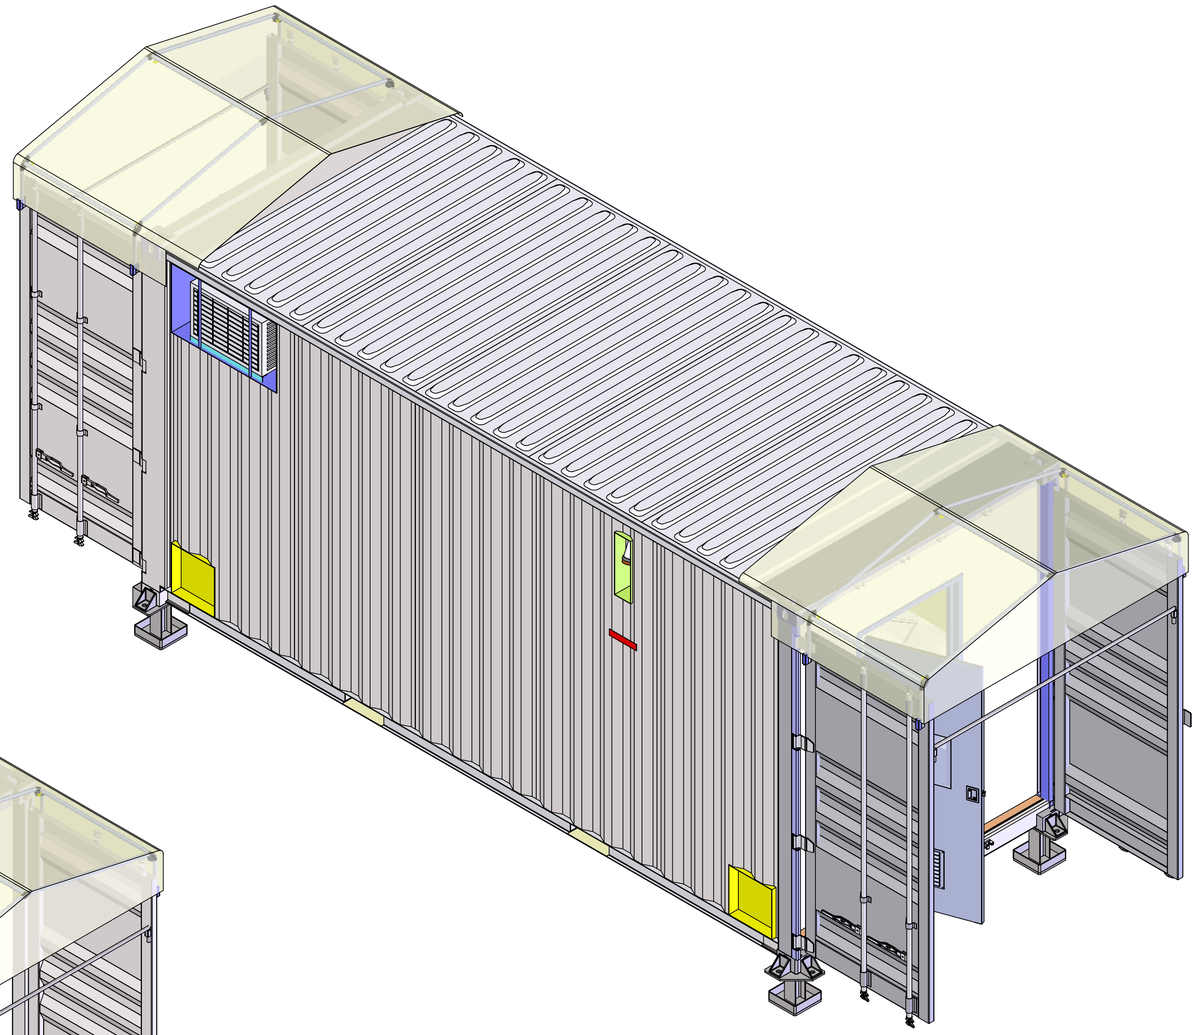

ISOMETRIC VIEWS
(DOORS OPENED POSITION
BUNGEE CARDS NOT SHOWN)

APPROVED

Royal Wolf Trading Australia Pty Ltd
ABN 38 069 244 417
www.royalwolf.com.au

Scale	1:20	
Mass	-- kg	
Drawn	SN	10/03/20
Checked	-	-
Designed	RWT	08/11/19
Approved	WL	10/03/20

General Fabrication Tolerances
0-50 mm ; ±0.5 mm
51mm-1M ; ±1.0 mm
1.001M - 6.1 M ; ±2.0 mm
6.101 M - 13 M ; ±3.0 mm

Customer: GRIFFITH UNI

Project: C-LAB

Division: SPECIAL PROJECTS

Title: C-LAB CONTAINER GENERAL ARRANGEMENT

THIS DRAWING IS THE PROPERTY OF ROYAL WOLF TRADING AUSTRALIA PTY LTD AND IS CONDITIONALLY LOANED TO THE RECIPIENT WHO BY RECEIVING IT HAS AGREED NOT TO REPRODUCE IT IN WHOLE OR IN PART, NOR MAKE ANY USE OF IT THAT HAS NOT BEEN APPROVED IN WRITING BY ROYAL WOLF TRADING AUSTRALIA PTY LTD

Sheet Size: A1 | Third Angle | Sheet No.: SHEET 5 OF 7

RWT Drawing Number: P19065-001

REV: 1

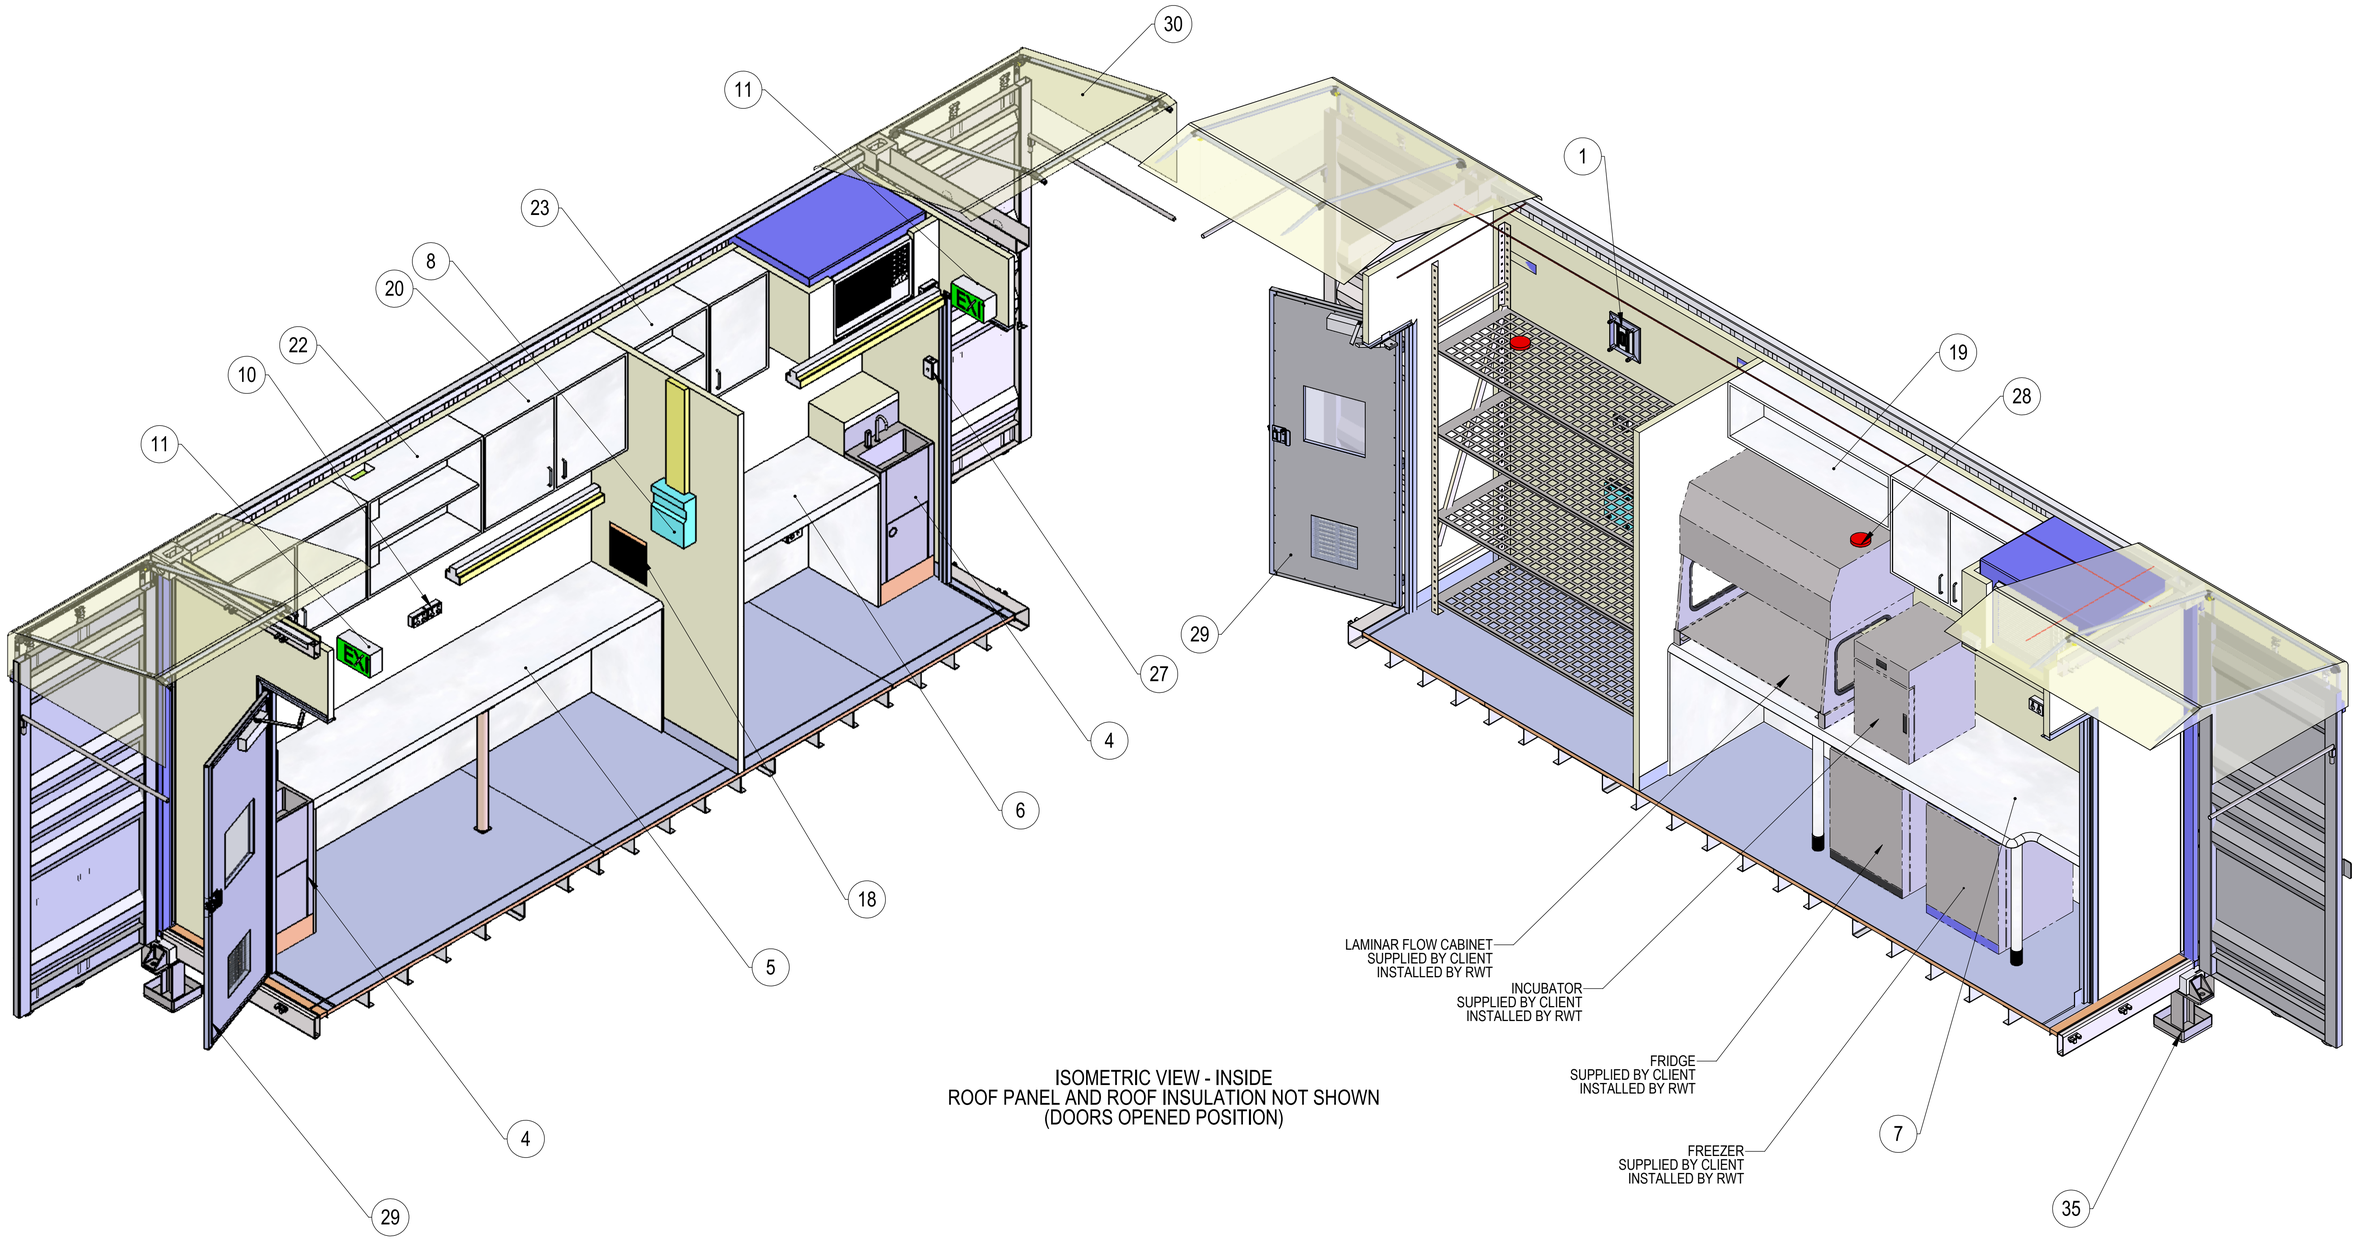

ISOMETRIC VIEW - INSIDE
ROOF PANEL AND ROOF INSULATION NOT SHOWN
(DOORS OPENED POSITION)

APPROVED

Royal Wolf Trading Australia Pty Ltd
ABN 38 069 244 417
www.royalwolf.com.au

Scale	1:20	
Mass	-- kg	
Drawn	SN	10/03/20
Checked	-	-
Designed	RWT	08/11/19
Approved	WL	10/03/20

General Fabrication Tolerances
0-50 mm ; ±0.5 mm
51mm-1M ; ±1.0 mm
1.001M - 6.1 M ; ±2.0 mm
6.101 M - 13 M ; ±3.0 mm

Customer: GRIFFITH UNI

Project: C-LAB

Division: SPECIAL PROJECTS

THIS DRAWING IS THE PROPERTY OF ROYAL WOLF TRADING AUSTRALIA PTY LTD AND IS CONDITIONALLY LOANED TO THE RECIPIENT WHO BY RECEIVING IT HAS AGREED NOT TO REPRODUCE IT IN WHOLE OR IN PART, NOR MAKE ANY USE OF IT THAT HAS NOT BEEN APPROVED IN WRITING BY ROYAL WOLF TRADING AUSTRALIA PTY LTD

Sheet Size: A1 | Third Angle | Sheet No.: SHEET 6 OF 7

Title: C-LAB CONTAINER GENERAL ARRANGEMENT

RWT Drawing Number: P19065-001

REV: 1

ITEM NO.	PART NUMBER	DESCRIPTION	QTY.	REMARKS
1	-	100mm EXHAUST FAN	2	
2	-	150mm EXHAUST FAN	1	
3	-	50MM EPS INSULATION	1	
4	-	BASIN - SELF CONTAINED	2	
5	-	BENCH - 600 WIDE	1	
6	-	BENCH - 600 WIDE	1	
7	-	BENCH - 800 WIDE	1	
8	-	DISTRIBUTION BOX - 24 POLE	1	
9	-	DOOR CLOSER - AUTOMATIC	2	
10	-	DOUBLE GPO 10Amp	7	
11	-	EMERGENCY EXIT LIGHT	2	
12	-	LED BATTEN LIGHT 36W, WITH TIMER AND OVER-RIDE FUNCTION	1	
13	-	LED BATTEN LIGHT 36W	1	
14	-	LED STRIP LIGHT	1	
15	-	LED STRIP LIGHT	1	
16	-	LED STRIP LIGHT	1	
17	-	LONGSPAN SHELVING 2500Hx2100Wx600D	1	POST : 2500 HEIGHT / ABSOE
18	-	MINI SHUTTER HATCH - 300 x 300	1	
19	-	OVER HEAD CUPBOARD, LAMINATED TIMBER	1	WITH S/S SASH LOCK
20	-	OVER HEAD CUPBOARD, LAMINATED TIMBER	2	WITH S/S SASH LOCK
21	-	OVER HEAD CUPBOARD, LAMINATED TIMBER	1	WITH S/S SASH LOCK
22	-	OVER HEAD SHELVES, LAMINATED TIMBER	1	
23	-	OVER HEAD SHELVES, LAMINATED TIMBER	1	
24	-	POWER INLET - 32AMP [IP 66 RATED]	1	
25	-	RIGHT ANGLE CONNECTOR - CHSTL	8	
26	-	SINGLE GPO 10Amp	4	
27	-	SINGLE LIGHT SWITCH	2	
28	-	SMOKE DETECTOR	2	
29	-	STD PA DOOR - LH (2090 x 895 FR. OPENING)	2	
30	-	TARP	2	COLOUR : WHITE C/W VELCRO STRAPS & BUNGEE CORDS
31	-	VINYL FLOOR WITH 100MM COVING	1	ARMSTRONG SAFEGUARD
32	P19065-001-001	20' HC HOTWORK	1	
33	P19065-P002	TARP HOLDER - 2	2	
34	P19065-P003	CONTAINER FOOT - LH	2	
35	P19065-P008	CONTAINER FOOT - RH	2	
36	RWT-STD002-0300	AC RECESS BOX	2	
37	RWT-ANCIL340-001	TENT FRAME ASSEMBLY	2	

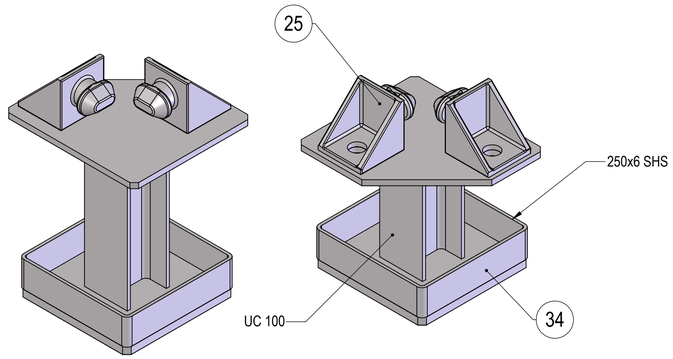

CONTAINER FOOT - LH

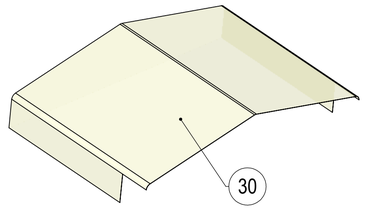

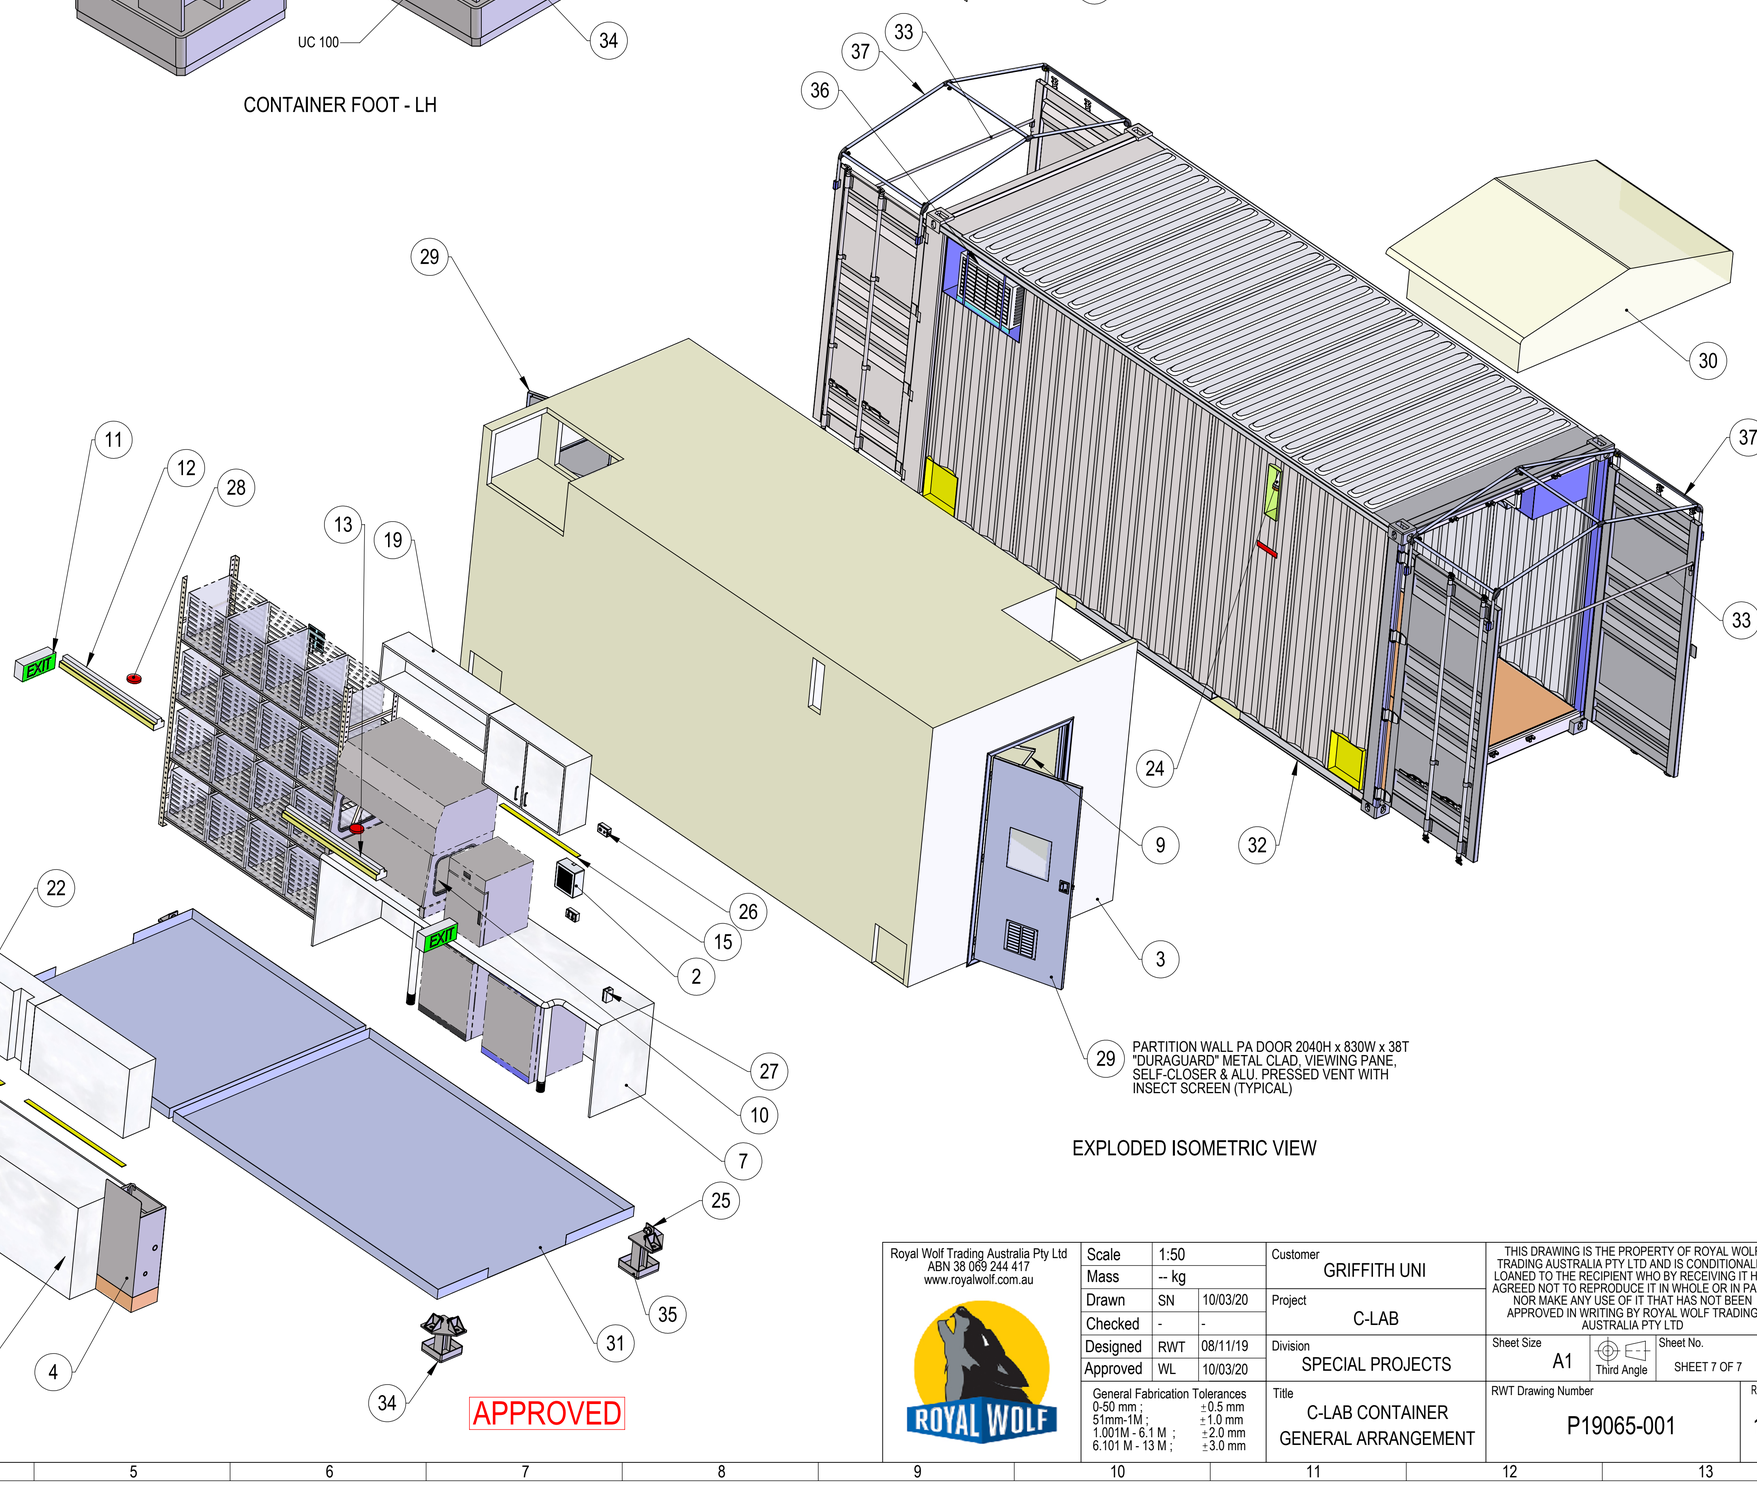

29 PARTITION WALL PA DOOR 2040H x 830W x 38T "DURAGUARD" METAL CLAD, VIEWING PANE, SELF-CLOSER & ALU. PRESSED VENT WITH INSECT SCREEN (TYPICAL)

EXPLODED ISOMETRIC VIEW

APPROVED

Royal Wolf Trading Australia Pty Ltd
ABN 38 069 244 417
www.royalwolf.com.au

Scale	1:50	
Mass	-- kg	
Drawn	SN	10/03/20
Checked	-	-
Designed	RWT	08/11/19
Approved	WL	10/03/20

General Fabrication Tolerances
0-50 mm ; ±0.5 mm
51mm-1M ; ±1.0 mm
1.001M - 6.1 M ; ±2.0 mm
6.101 M - 13 M ; ±3.0 mm

Customer: GRIFFITH UNI

Project: C-LAB

Division: SPECIAL PROJECTS

THIS DRAWING IS THE PROPERTY OF ROYAL WOLF TRADING AUSTRALIA PTY LTD AND IS CONDITIONALLY LOANED TO THE RECIPIENT WHO BY RECEIVING IT HAS AGREED NOT TO REPRODUCE IT IN WHOLE OR IN PART, NOR MAKE ANY USE OF IT THAT HAS NOT BEEN APPROVED IN WRITING BY ROYAL WOLF TRADING AUSTRALIA PTY LTD

Sheet Size: A1 | Third Angle | Sheet No.: SHEET 7 OF 7

Title: C-LAB CONTAINER GENERAL ARRANGEMENT

RWT Drawing Number: P19065-001

REV: 1